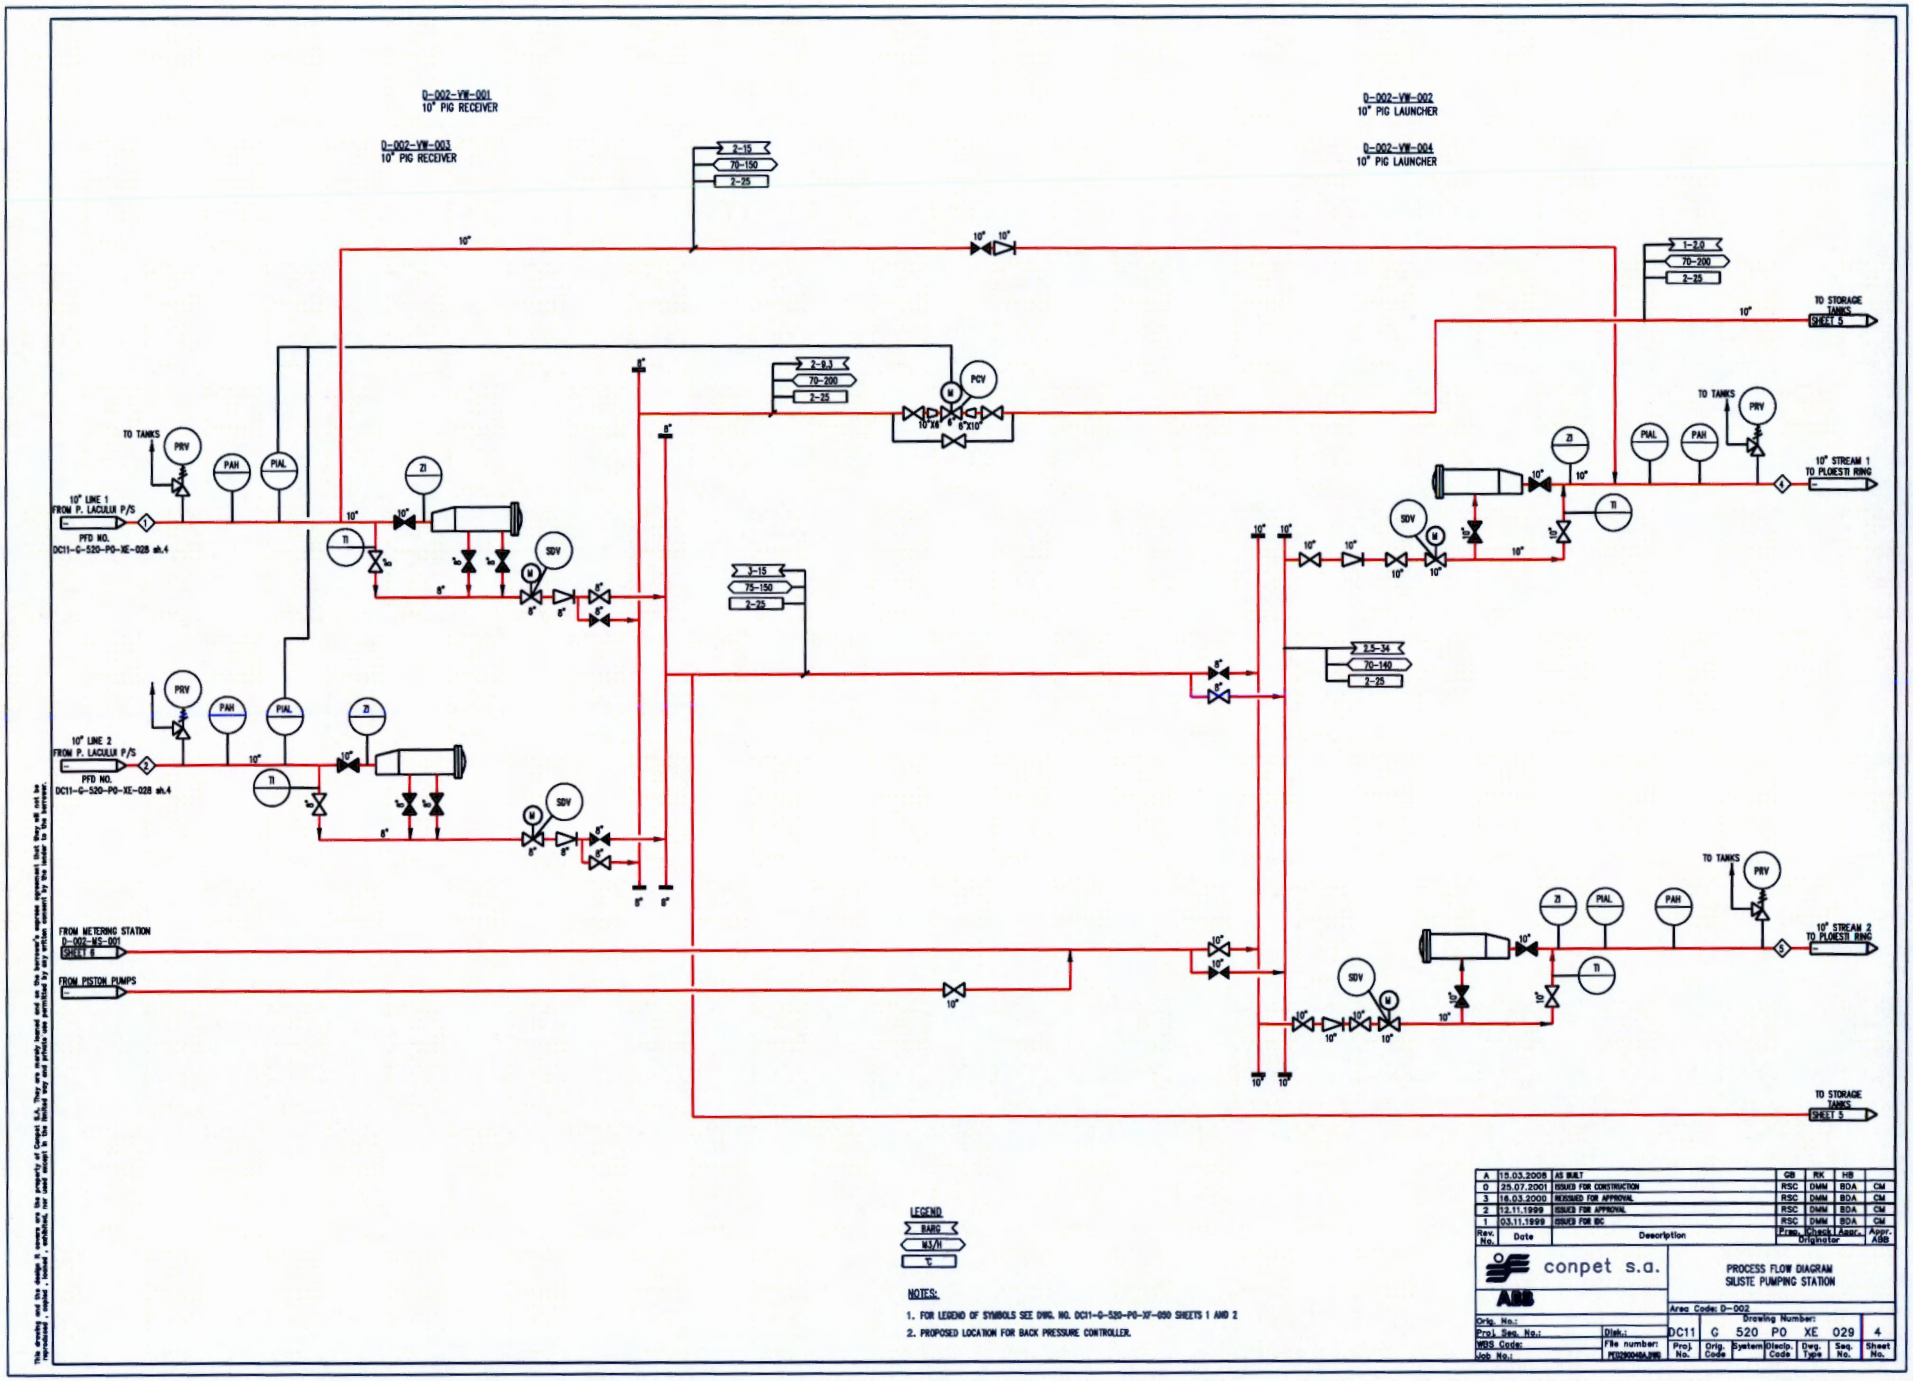

Rev. No.	Date	Description	Drawn	Check	Assoc. Originator	Appr. ABB
A	15.03.2008	AS BUILT	GB	RK	HB	
0	25.07.2001	ISSUED FOR CONSTRUCTION	RSC	DMM	BDA	CM
3	16.03.2000	REISSUED FOR APPROVAL	RSC	DMM	BDA	CM
2	12.11.1999	ISSUED FOR APPROVAL	RSC	DMM	BDA	CM
1	03.11.1999	ISSUED FOR IDC	RSC	DMM	BDA	CM

conpet s.a.

ABB

PROCESS FLOW DIAGRAM
SILISTE PUMPING STATION

Area Code: D-002

Orig. No.:		Drawing Number:							
Proj. Seq. No.:	Disk.:	DC11	G	520	PO	XE	029	4
MRS Code:	File number: P520G050A.DWG	Proj. No.	Orig. Code	System	Descip. Code	Dwg. Type	Seq. No.	Sheet No.
Job No.:								

This drawing and this design it covers are the property of Conpet S.A. They are strictly loaned and as the borrower's express agreement that they will not be reproduced, copied, loaned, exhibited, nor used except in the limited way and purpose and period as may be agreed upon in writing by the issuer to this borrower.